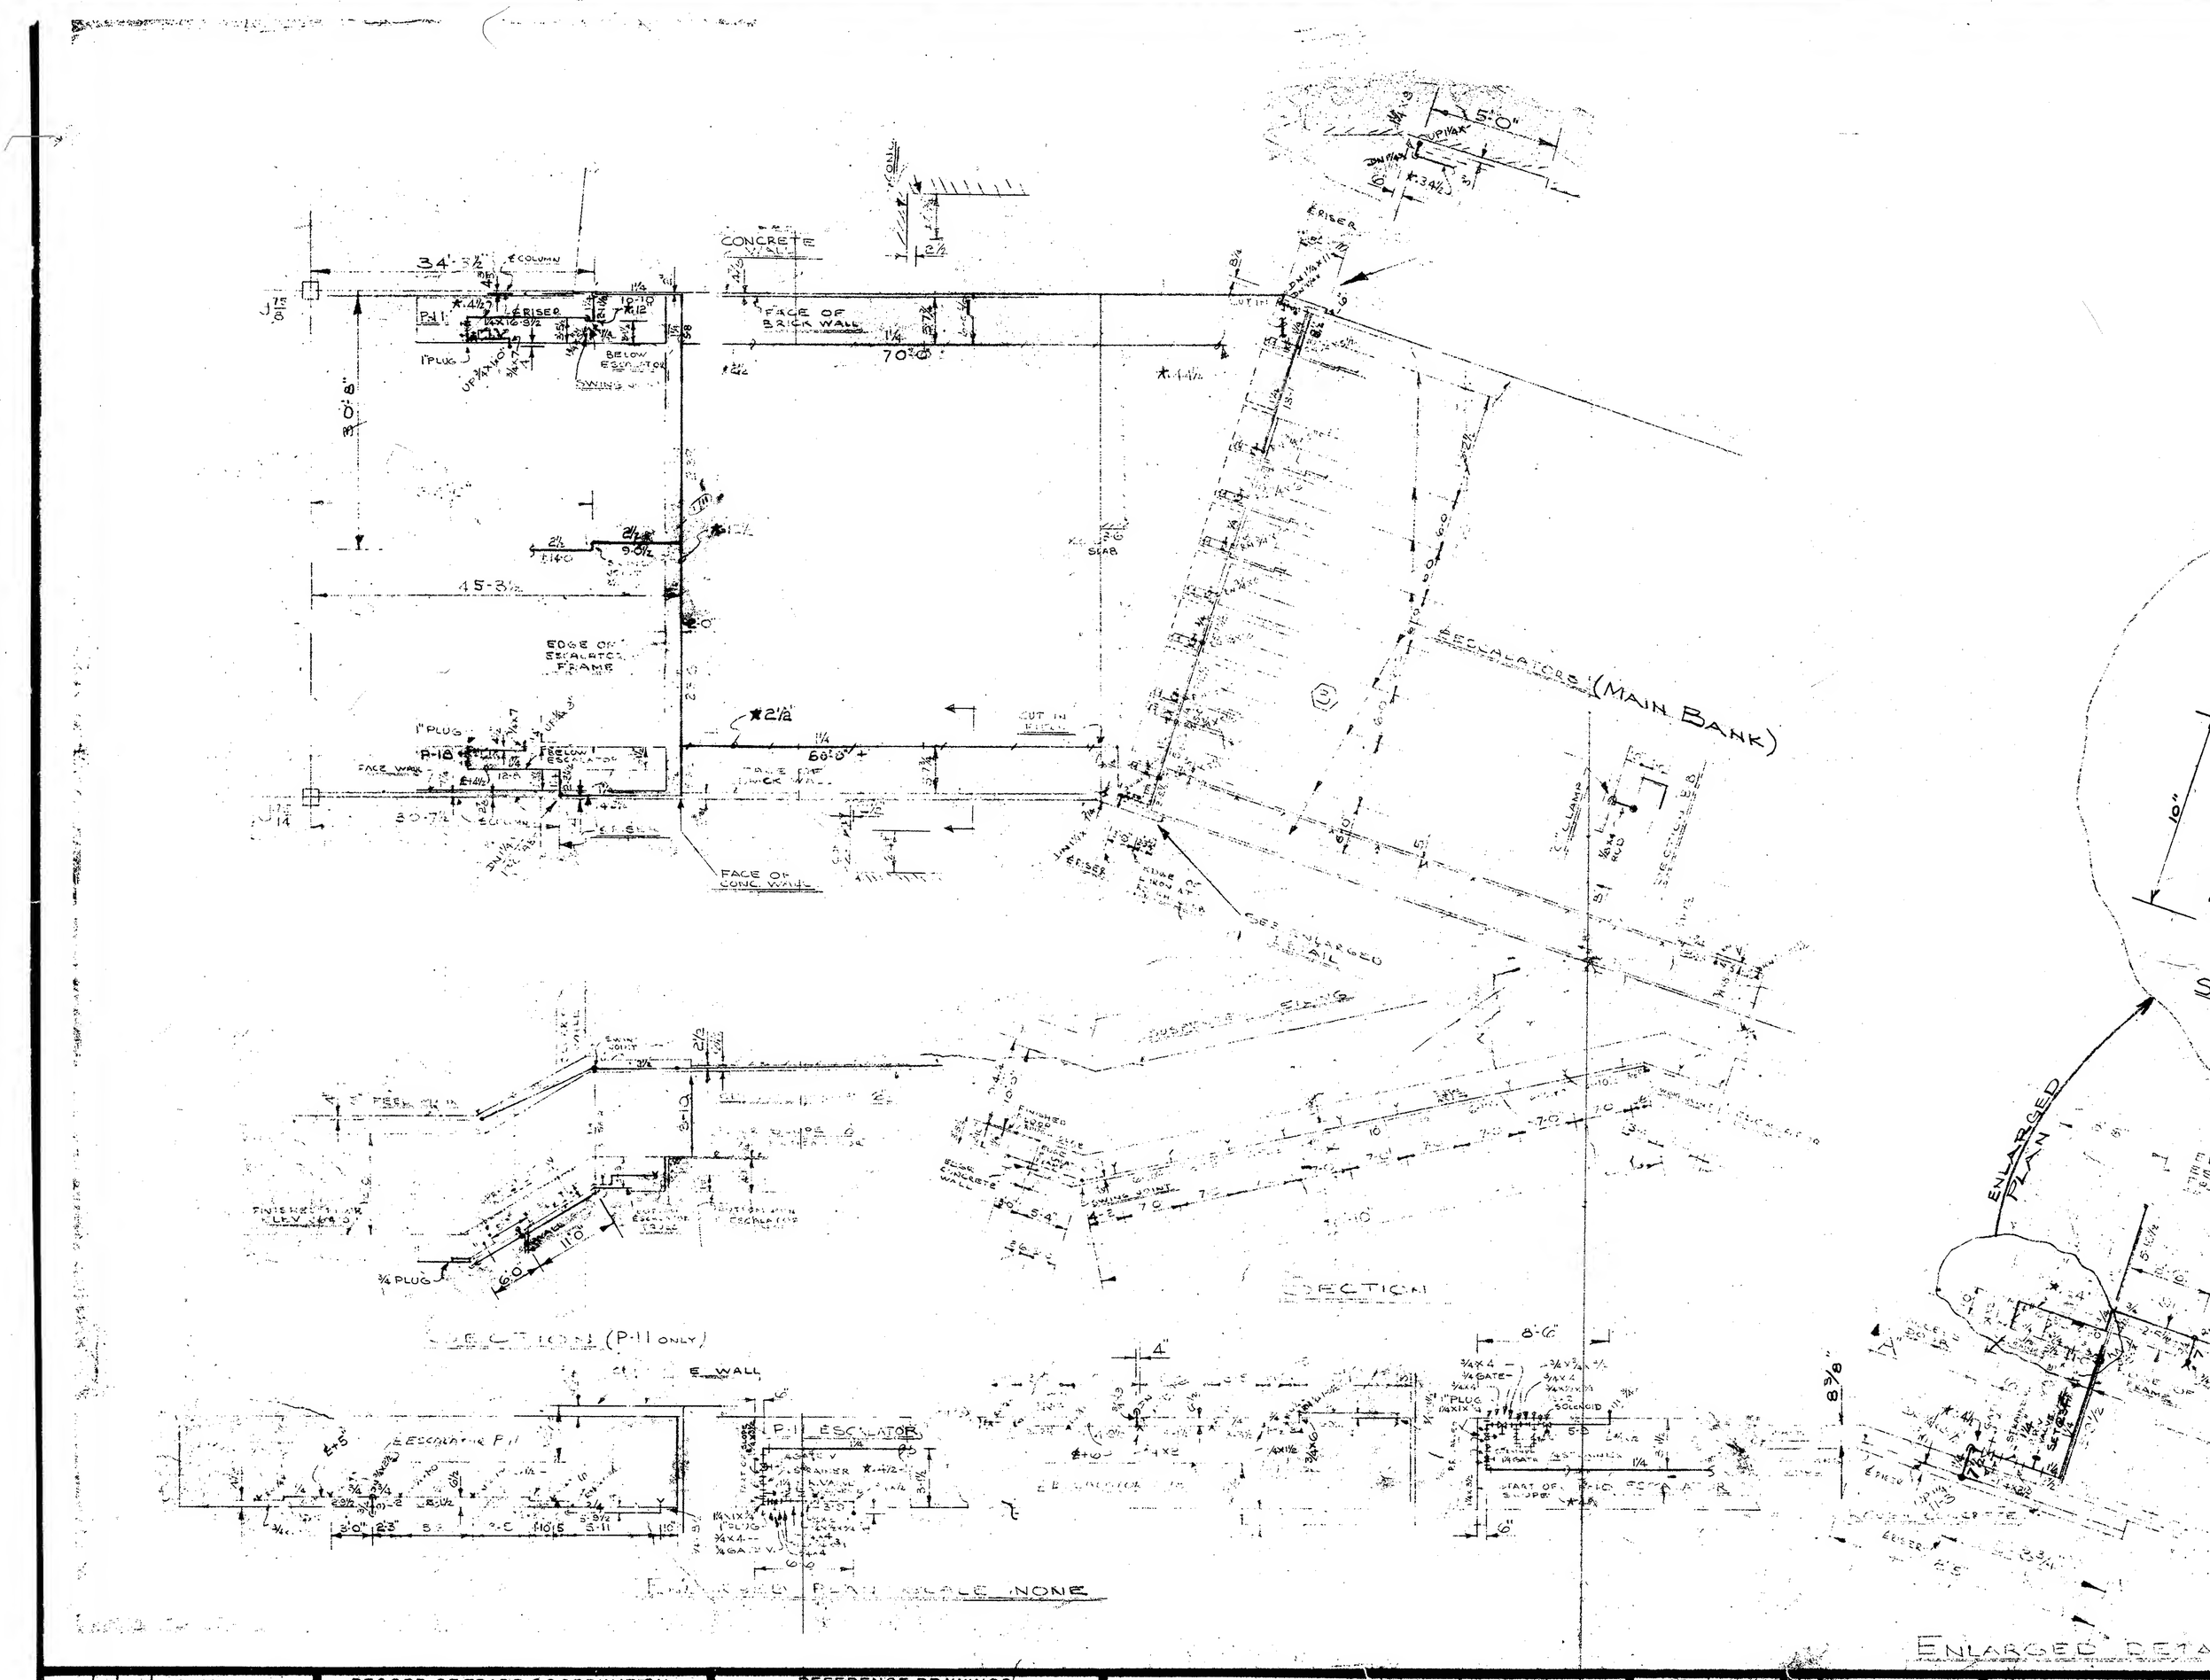

RECORD OF TRADE COORDINATION

TRADE	COMPANY	BY	DATE
HVAC	SAND-COURTER		
SHEET METAL	ALPINE-BROOK-TRIANGLE		
PLUMBING	JARCHO BROS.		
ELECTRICAL	NAGER ELECTRIC CO.		

RECORD OF FINAL PLAN APPROVAL

AUTHORITY	NAME	BY	DATE
P.O.N.Y.A.			
J. B. & B.			
N.Y.F.I.R.O.			

DISTRIBUTED TO

DISTRIBUTION RECORD

REFERENCE DRAWINGS

INFORMATION	BY	DWG. NO	DATE	LATEST REV. NO	DATE
ARCHITECT		AP [illegible]	1-22-69	2	[illegible]
		AP 96	5-22-68	5	[illegible]

LEGEND OF SYMBOLS

ABBREVIATIONS

- MD MAIN DESIGNATION
- BD BRANCH DESIGNATION
- WMG WATER MOTOR GONG
- ABD AUTO BALL DRIP
- FC FLUSHING CONN.
- FDC FIRE DEPT. CONN.
- ITC INSP. TEST CONN.
- C-C CENTER TO CENTER
- T&G THREAD BY GROOVE
- PE PLAIN END
- RN RISE NIPPLE
- DN DROP NIPPLE
- OWSJ OPEN WEB STEEL JOIST
- WJ WOOD JOIST
- WF,BM BEAM DESIGNATIONS
- CB CONCRETE BEAM
- COL COLUMN
- DO DITTO
- H.C. HUNG CEILING
- SG SPRINKLER GUARD
- AFF ABOVE FINISHED FLOOR

INFORMATION ALONG PIPE LINES

HANGER — Type, Rod Length, Location
PIPE — Size, Cut Length
ELEVATION — Above Slab or Top of Steel; Below Slab, Abv. Fin. Flr.; Below Bottom of Steel; Below Bottom of Duct

- ALARM CHECK VALVE (A.V.)
- DRY VALVE (D.V.)
- D.V. WITH EXHAUSTER
- WATER FLOW DETECTOR (W.F.D.)
- O.S.&Y. GATE VALVE
- CHECK VALVE
- POST INDICATOR VALVE (P.I.V.)
- WALL P.I.V.

STANDARD HANGERS

- C-CLAMP
- OFFSET C-CLAMP
- 2 NUTS, WASHER
- EXPANSION SHIELD
- INSERT NUT
- TOGGLE
- LAG ROD
- BEAM CLAMP
- SIDE-ROD
- HORIZ. LAG BOLT
- HORIZ. EXP. SHIELD
- TRAPEZE BAR
- YOKE STAND

SPRINKLER HEAD TABULATION

MFR'S MODEL NO.	SIZE	TYPE	FINISH	SYMBOL	TEMPERATURE RATING 160°	212°	280°	OPEN
		UPR. SHT	GLASS					
		PENDANT	BRASS					
		PENDANT	CHROME					
		FLUSH PENDANT	CHROME					
FULLER	1/8	NOZZLE	[illegible]					129

TOTAL NOZZLES ON THIS SHEET 129

TOTAL SPRINKLERS ON ENTIRE JOB

REVISIONS

NO	DATE	BY	DESCRIPTION
		LM	PIPE [illegible]
2	Oct 27/70	LM	DETAILS ADDED FOR [illegible] AVOID SHOWN.
	Nov 6/70	LM	NOTE ADDED. [illegible]
4	DEC 31/70	LM	ESCALATORS [illegible]
5	2-10-75	[illegible]	AS INSTALLED

ARCHITECT: MINORU YAMASAKI & A[illegible] EMORY ROTH & SONS

MECHANICAL ENGINEER: [illegible] FARM & ROLLES

DISTRICT: PORT OF NEW YORK A[illegible]